


SCHOONER BAY PLAZA
 FOR
SCHOONER BAY PLAZA, L.L.C.
 AT
 LEE COUNTY, FLORIDA

09-25-07

01.30.07 P.5.	
02.23.07 D.D.	
MARK DATE DESCRIPTION	
A.B. AS-BUILT	
R.A.P. REVISION AFTER PERMITS	
R.A.P. REVISION AFTER PERMITS	
C.C. COORDINATION CHANGES	
P.S. PERMIT SET	
P.H. PUBLIC HEARING	
PROJECT No. 200704319	
DRAWN BY: A. Viegna	
CHECKED BY: A.M. / L.B.	

LEOPOLDO BELION, AA (AR-008727)
 ANGELO MILANES, AA (AR-2015846)

BUILDING
 FLOOR PLANS
AE-101
 SHEET N OF N

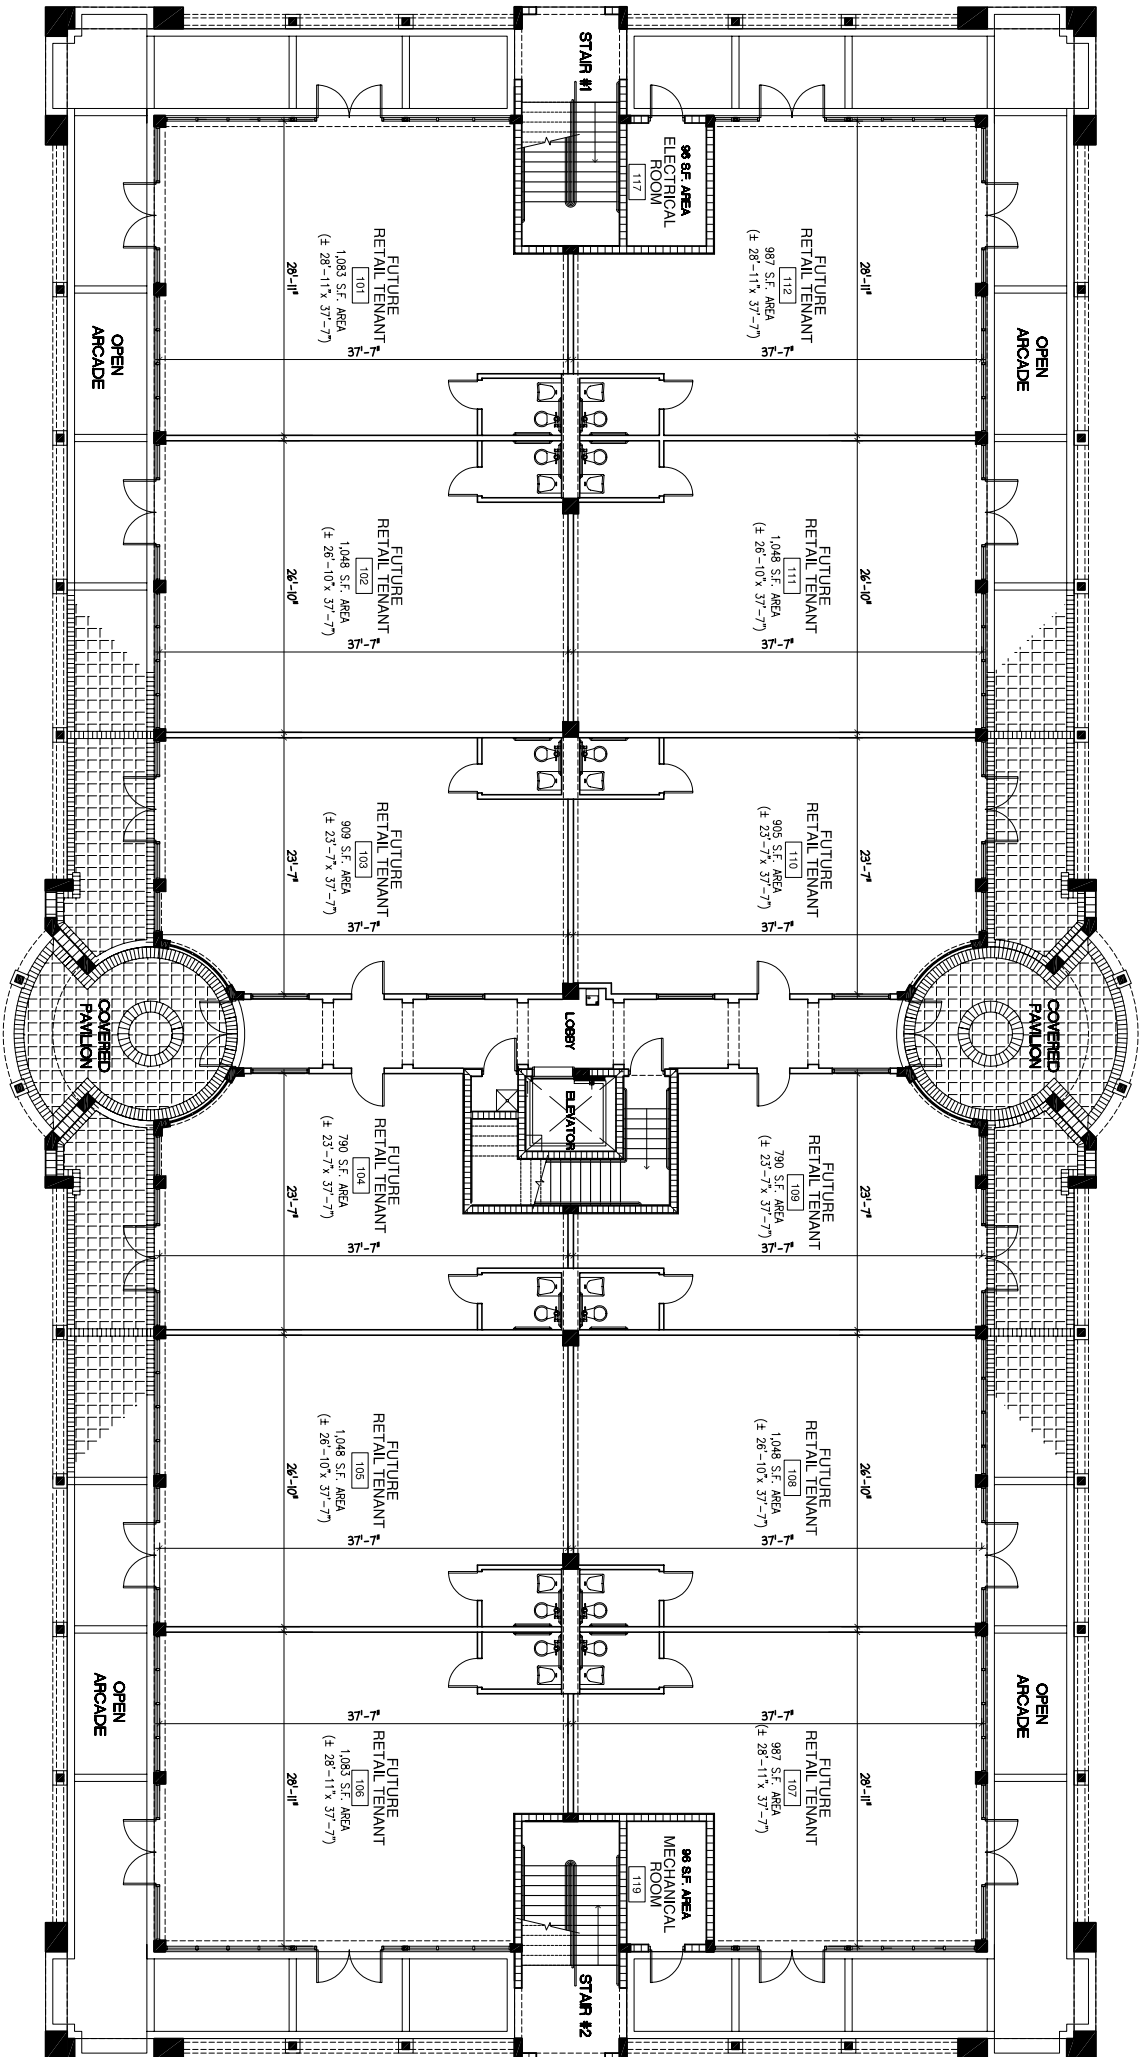

1 GROUND FLOOR PLAN
 SCALE: 1/8" = 1'-0"

AREA BREAKDOWN GROUND FLOOR	
NON-AC SPACES	
COVERED ENTRY PORTICO	610 S.F.
COVERED OPEN ARCADE	3,928 S.F.
COVERED OPEN STAIRS	468 S.F.
TOTAL (NON-AC SPACES)	5,006 S.F.
AC SPACES	
RETAIL SPACE	11,876 S.F.
INT. STAIRS, MECHANICAL ROOMS & ELEVATOR	463 S.F.
INTERIOR HALLWAYS, ELEVATOR LOBBY	419 S.F.
TOTAL (AC SPACES)	12,758 S.F.
SUBTOTAL (AC AND NON-AC SPACES)	17,764 S.F.
TOTAL GROUND FLOOR	17,764 S.F.